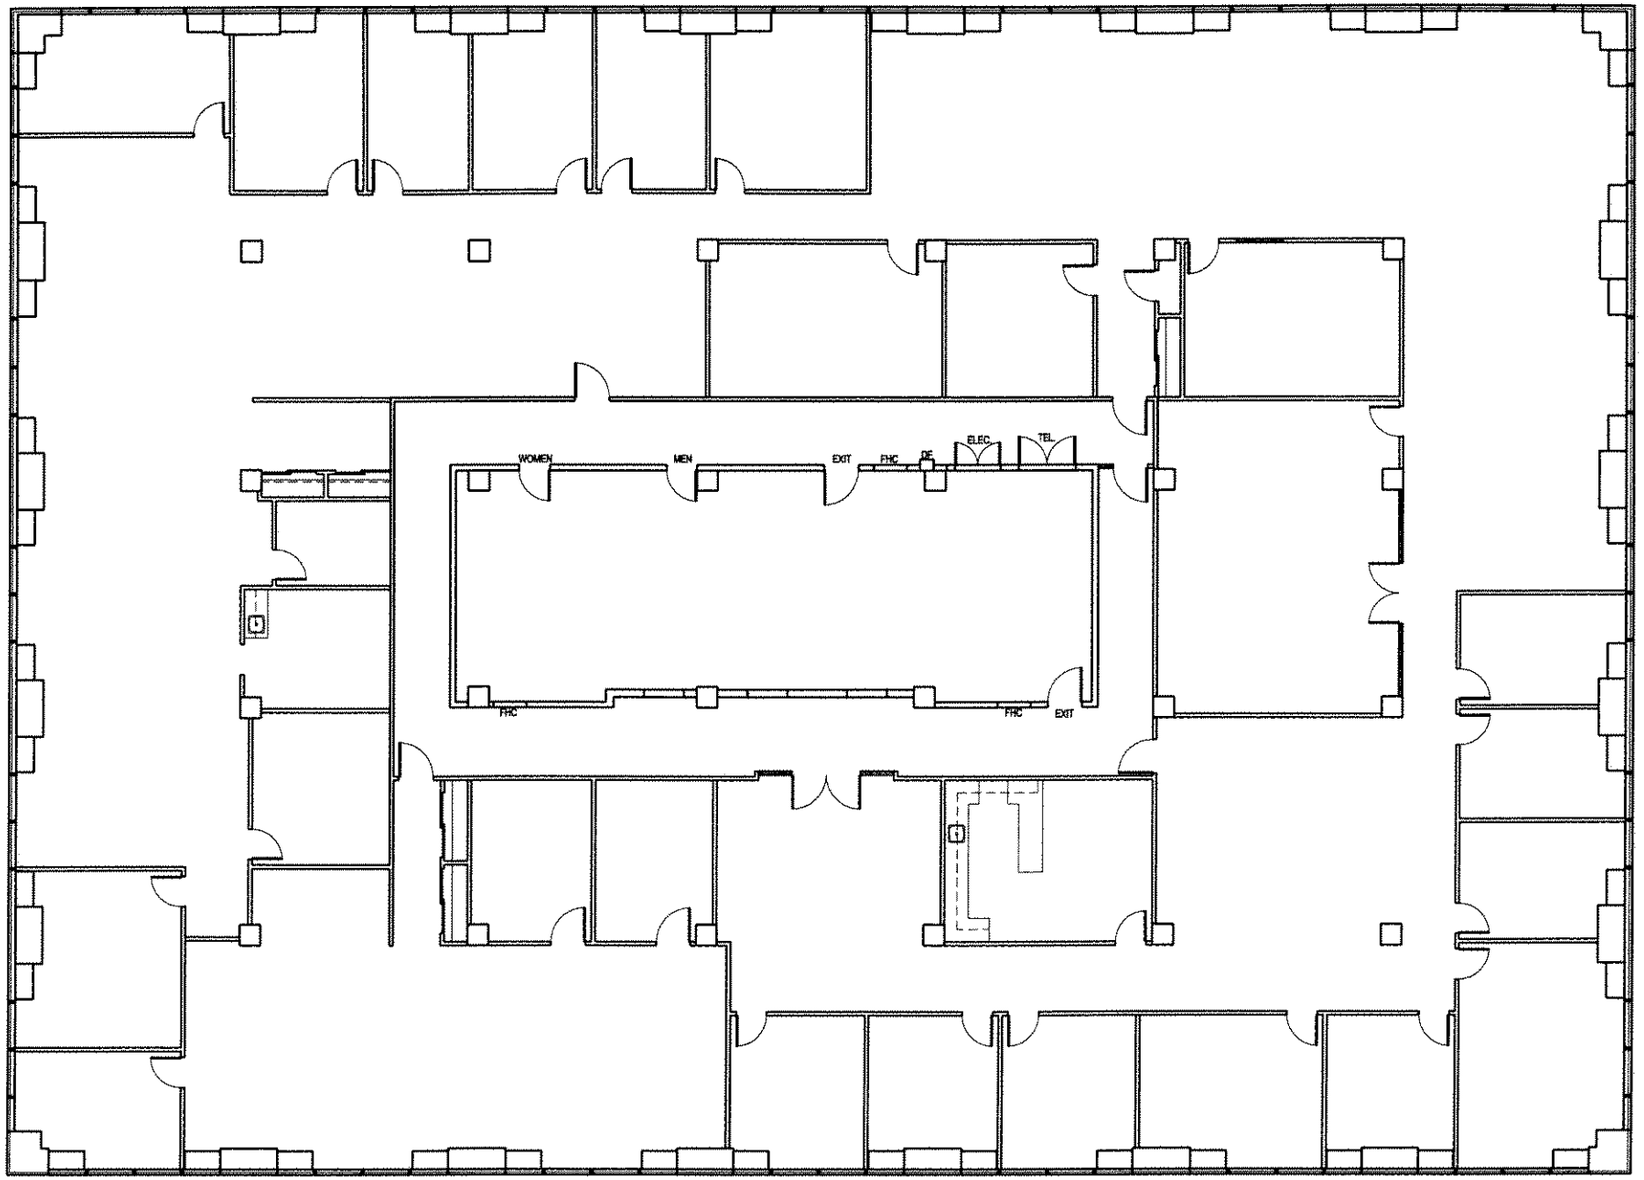

NO.	DESCRIPTION	DATE	CHD.

REVISIONS

CONTRACTOR TO VERIFY ALL DIMENSIONS ON SITE AND REPORT DISCREPANCIES TO THE DESIGNER BEFORE COMMENCING WORK.

DO NOT SCALE DRAWINGS.

DRAWINGS AND SPECIFICATIONS ARE THE PROPERTY OF LEMBINSKA BROOKS APIGIAN INC. AND SHALL NOT BE USED FOR CONSTRUCTION UNLESS SIGNED BY DESIGNER.

NORTH

DRAWN BY	DATE	CHECKED
AB	MAY 17/05	SL

PROJECT

250 CONSUMERS ROAD
8TH FLOOR

DRAWING TITLE

AS-BUILT

PROJECT NO.	DRAWING NO.	SCALE
05-019	A-1	1/8"=1'-0"

DESIGNERS

LBA

250 Merton Street, Suite 300
Toronto, Ontario, Canada
M4S 1B1

T: 416-486-3001
F: 416-486-6791
lba-design.com